




BENOIST FARMS ROAD UTILITY ADJUSTMENTS

PREPARED FOR

PALM BEACH COUNTY WATER UTILITIES DEPARTMENT

WUD PROJECT NO. 21-014
PALM BEACH COUNTY, FL
MARCH 2021

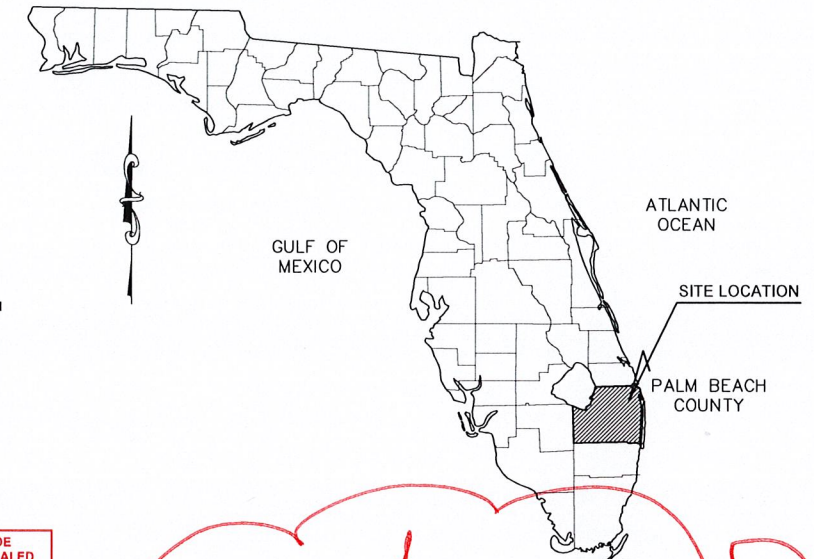

Add "For Potable Water only"

PRELIMINARY RECORD DRAWINGS
JUNE 2023


PLEASE PROVIDE
SIGNED AND SEALED
DRAWINGS FOR
SUBMISSION TO
HEALTH DEPARTMENT

Reviewed
on 9/11/2023 - mR

BOARD OF COUNTY COMMISSIONERS

DAVE KERNER, MAYOR, DISTRICT 3
ROBERT S. WEINROTH, VICE MAYOR, DISTRICT 4
MARIA G. MARINO, DISTRICT 1
GREGG K. WEISS, DISTRICT 2
MARIA SACHS, DISTRICT 5
MELISSA MCKINLAY, MAYOR, DISTRICT 6
MACK BERNARD, DISTRICT 7

AUGUST?

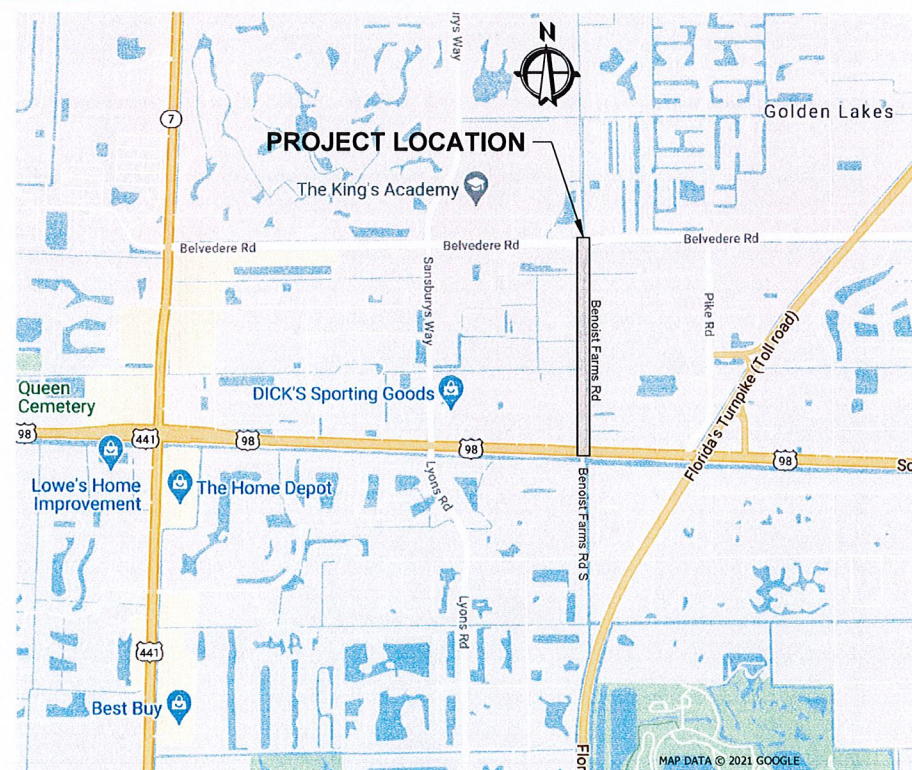

VICINITY MAP

N.T.S.
SECTIONS 27, 32, TOWNSHIP 43 SOUTH, RANGE 42 EAST

- SURVEYOR'S RECORD ASBUILT NOTES:
1. CERTIFICATION BY THE SIGNING SURVEYOR AND MAPPER IS LIMITED TO THE RECORD (AS-BUILT) INFORMATION ADDED TO THE PLAN, AND IS NOT LIABLE FOR ANY OTHER INFORMATION SHOWN.
 2. NOT VALID WITHOUT THE SIGNATURE AND THE ORIGINAL RAISED SEAL OF A FLORIDA LICENSED SURVEYOR AND MAPPER.
 3. LANDS SHOWN HEREON WERE NOT ABSTRACTED BY THE SURVEYOR FOR RIGHTS-OF-WAY AND/OR EASEMENTS OF RECORD OR OWNERSHIP.
 4. ADDITIONS OR DELETIONS TO SURVEY MAPS OR REPORTS BY OTHER THAN THE SIGNING PARTY OR PARTIES IS PROHIBITED WITHOUT WRITTEN CONSENT OF THE SIGNING PARTY OR PARTIES.
 5. ELEVATIONS SHOWN HEREON ARE RELATIVE TO THE NORTH AMERICAN VERTICAL DATUM OF 1988 (NAVD88), AND ARE REFERENCED TO THE 57 PROJECT CONTROL POINTS.

RECORD DRAWINGS SURVEY LEGEND

BFV = BUTTERFLY VALVE
E = STATE PLANE EASTING
EL = ELEVATION
GV = GATE VALVE
INV = INVERT
LB = LICENSED BUSINESS
LT = LEFT OFFSET
N = STATE PLANE NORTHING
PSM = PROFESSIONAL SURVEYOR AND MAPPER
RT = RIGHT OFFSET
STA. = STATION
TON = TOP OF NUT
TOP = TOP OF PIPE/ FITTING

FG = Finished Grade

SURVEYOR'S RECORD DRAWINGS CERTIFICATE:

I HEREBY CERTIFY THAT THE RECORD AS-BUILT DATA SHOWN HEREON IS DEPICTED TO TO THE BEST OF MY KNOWLEDGE, BELIEF, AND INFORMATION SURVEYED UNDER MY DIRECTION. I FURTHER CERTIFY THAT THIS RECORD SURVEY MEETS THE STANDARDS OF PRACTICE, AS SET FORTH BY THE FLORIDA BOARD OF PROFESSIONAL SURVEYORS AND MAPPERS IN CHAPTER 5J-17, FLORIDA ADMINISTRATIVE CODE, PURSUANT TO SECTION 472.027, FLORIDA STATUTES, SUBJECT TO THE QUALIFICATIONS NOTED HEREON.

DATE: 06-15-2023

BY: KENNETH DRURY, P.S.M.
FLORIDA REGISTRATION NO. 6084
ATLAS SURVEYING AND MAPPING, INC. LB# 7449
612 SKYLAKE DRIVE WEST PALM BEACH, FLORIDA, 33415
CELL: 561-248-8339 ATLASAMI@AOL.COM



BAR IS EQUAL TO ONE INCH
ON ORIGINAL DRAWING
ADJUST ALL SCALED
DIMENSIONS ACCORDINGLY

ELEVATIONS SHOWN
HEREON ARE RELATIVE
TO THE NORTH
AMERICAN VERTICAL
DATUM OF 1988 (NAVD88)

NO.	DATE	BY	REVISION
1	8/17/2022	MCV	REVISED SHEETS C1-2 AND C1-6 PER PBCWUD COMMENTS.
2	10/05/2021	MCV	REVISED SHEETS C1-2, C1-7 AND C1-8 PER PBCWUD COMMENTS.

ATLAS Surveying and Mapping, Inc.
612 SKYLAKE DRIVE, WEST PALM BEACH, FLORIDA, 33415
CELL (561)-248-8339 LB: 7449 ATLASAMI@AOL.COM

SEAL
JOHN P. CAIRNES
FLORIDA P.E. NO. 74737
DATE

FLORIDA C.A. NO. 48

MOCK•ROOS
CONSULTING ENGINEERS

5720 Corporate Way, West Palm Beach, Florida 33407 (561) 683-3113, www.MockRoos.com


FLORIDA L.B. NO. 48

FIELD: ---
DRAWN: MCV
DESIGN: JPC
APPR: GGG
SCALE: 1" = 1'

PBCWUD #21-014
PRELIMINARY RECORD DRAWINGS, JUNE 2023

BENOIST FARMS ROAD
UTILITY ADJUSTMENTS
PALM BEACH COUNTY
WATER UTILITIES DEPARTMENT
PALM BEACH COUNTY, FL

DATE: MARCH 2021
P.A. NO. C0061.00
DWG. NO. 43-42-27-20
SHEET: C0-1

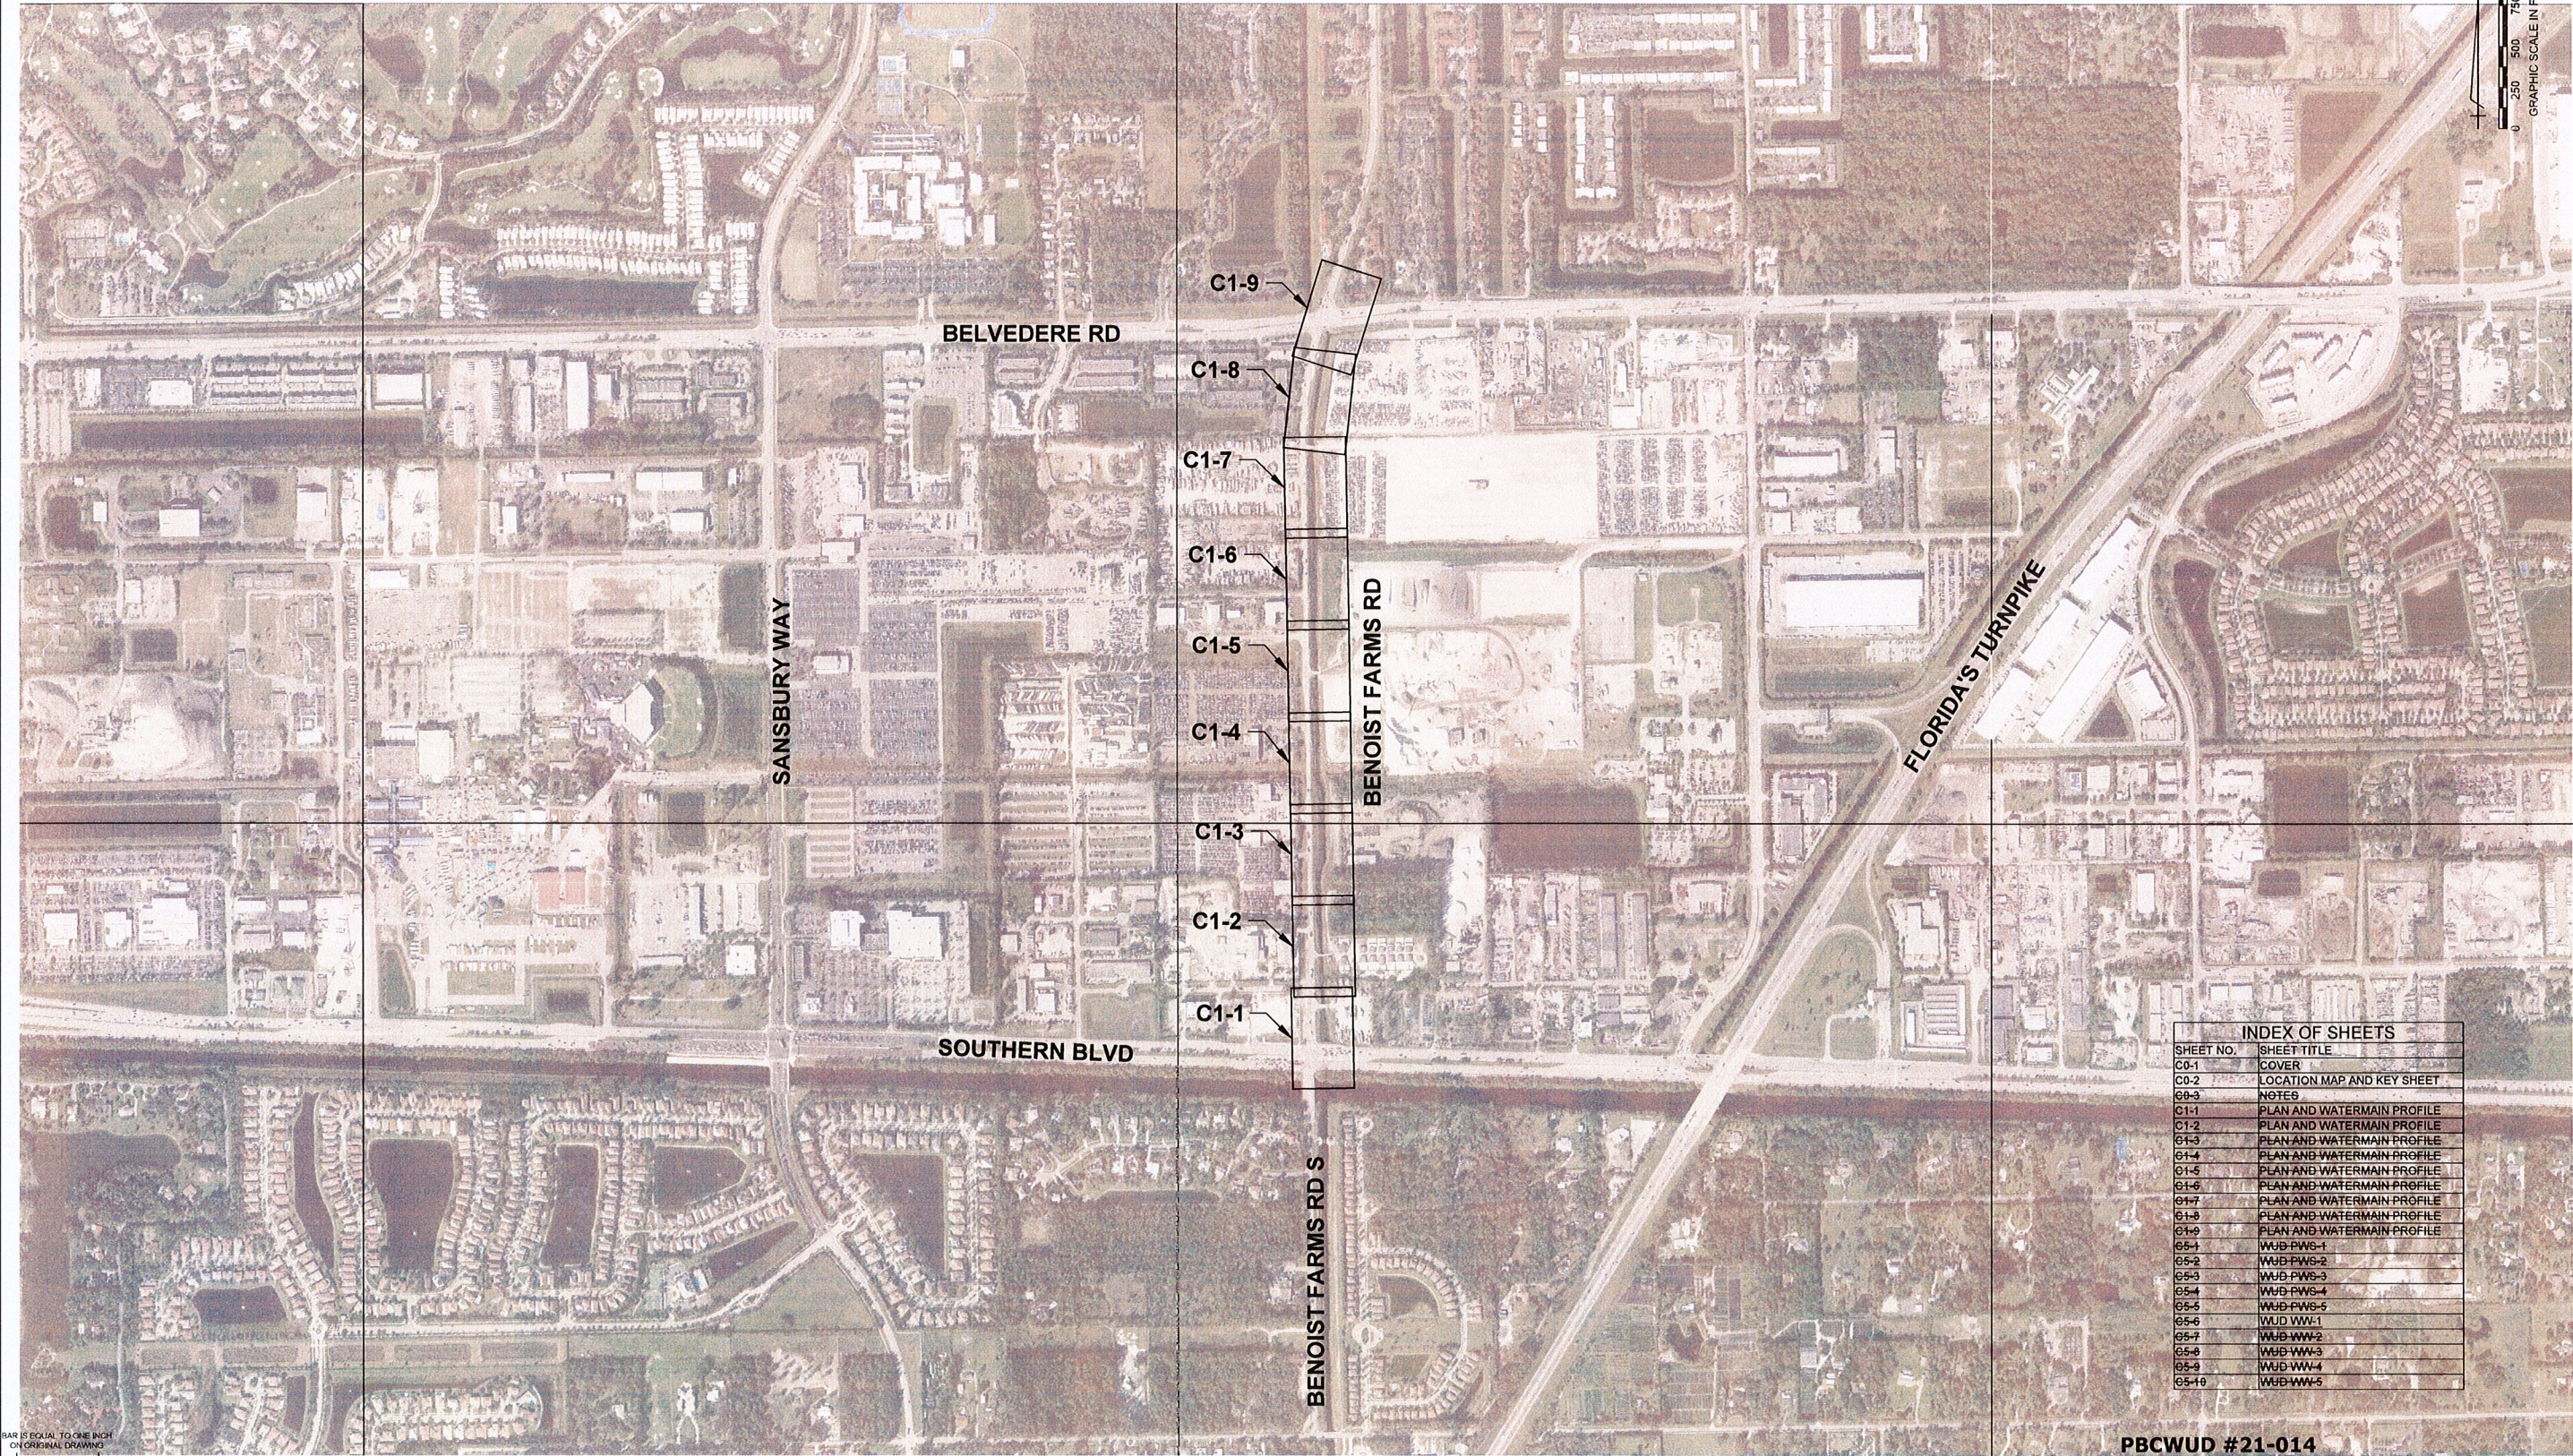



INDEX OF SHEETS	
SHEET NO.	SHEET TITLE
C0-1	COVER
C0-2	LOCATION MAP AND KEY SHEET
60-3	NOTES
C1-1	PLAN AND WATERMAIN PROFILE
C1-2	PLAN AND WATERMAIN PROFILE
61-3	PLAN AND WATERMAIN PROFILE
61-4	PLAN AND WATERMAIN PROFILE
61-5	PLAN AND WATERMAIN PROFILE
61-6	PLAN AND WATERMAIN PROFILE
61-7	PLAN AND WATERMAIN PROFILE
61-8	PLAN AND WATERMAIN PROFILE
61-9	PLAN AND WATERMAIN PROFILE
65-1	WUD PWS-1
65-2	WUD PWS-2
65-3	WUD PWS-3
65-4	WUD PWS-4
65-5	WUD PWS-5
65-6	WUD WW-1
65-7	WUD WW-2
65-8	WUD WW-3
65-9	WUD WW-4
65-10	WUD WW-5

PBCWUD #21-014
PRELIMINARY RECORD DRAWINGS, JUNE 2023

ELEVATIONS SHOWN HEREON ARE RELATIVE TO THE NORTH AMERICAN VERTICAL DATUM OF 1988 (NAVD88) CADD FILE: BENC0501 C0-2.dwg	ATLAS Surveying and Mapping, Inc. 612 SKYLAKE DRIVE, WEST PALM BEACH, FLORIDA, 33415 CELL (561)-248-8339 LB:7449 ATLASAMI@AOL.COM				SEAL JOHN P. CAIRNES FLORIDA P.E. NO. 74737	FLORIDA C.A. NO. 48	MOCK • ROOS CONSULTING ENGINEERS 5720 Corporate Way, West Palm Beach, Florida 33407 (561) 683-3113, www.MockRoos.com	FLORIDA L.B. NO. 48	FIELD: --- DRAWN: MCV DESIGN: JPC APPR: GGG SCALE: 1" = 1'	BENOIST FARMS ROAD UTILITY ADJUSTMENTS PALM BEACH COUNTY WATER UTILITIES DEPARTMENT PALM BEACH COUNTY, FL	DATE: MARCH 2021 P.A. NO. C0061.00 DWG. NO. 43-42-27-20 SHEET: C0-2
	NO.	DATE	BY	REVISION	DATE						

PLOT DATE: Sep 05, 2023 - 7:51am
BAR IS EQUAL TO ONE INCH
ON ORIGINAL DRAWING
ADJUST ALL SCALED
DIMENSIONS ACCORDINGLY

By providing the Finished Grade @ each Call out (F.G. = ?)

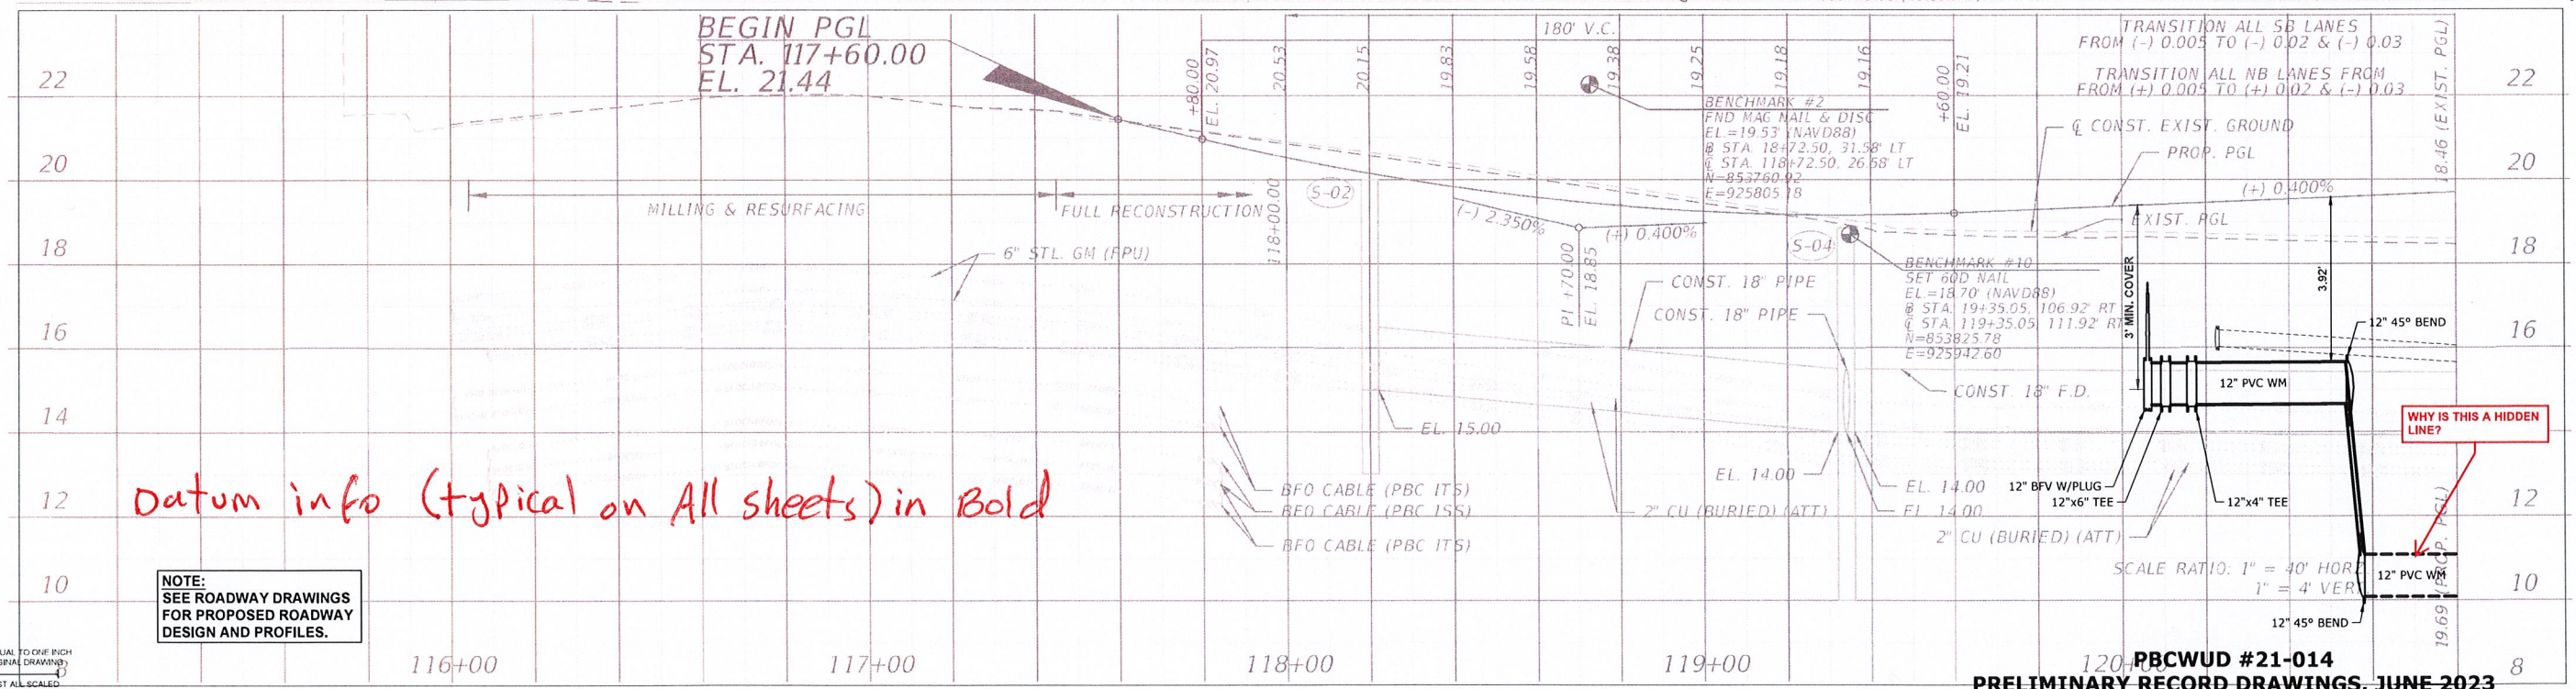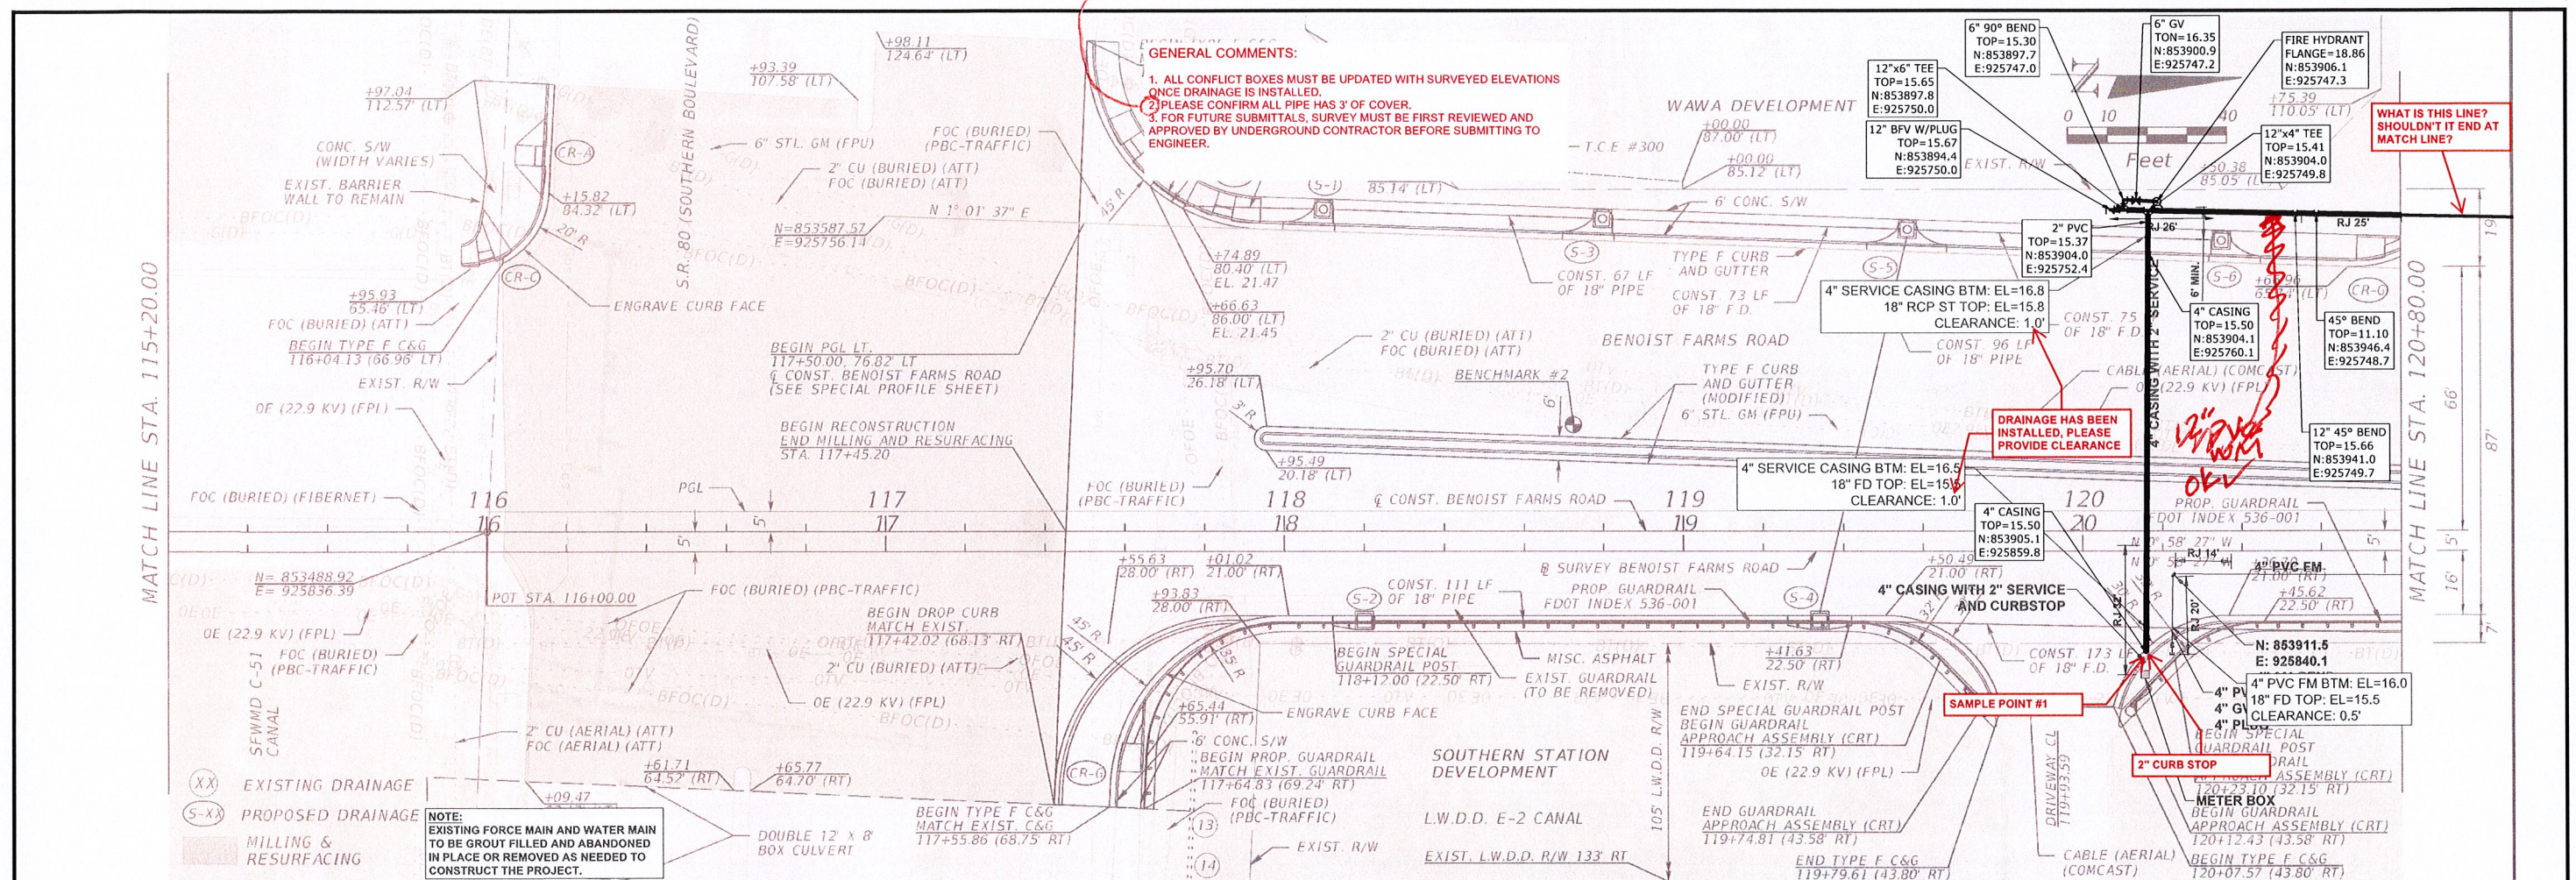

Datum info (typical on All sheets) in Bold

NOTE:
SEE ROADWAY DRAWINGS
FOR PROPOSED ROADWAY
DESIGN AND PROFILES.

BAR IS EQUAL TO ONE INCH
ON ORIGINAL DRAWING
ADJUST ALL SCALED
DIMENSIONS ACCORDINGLY

ELEVATIONS SHOWN
HEREON ARE RELATIVE
TO THE NORTH
AMERICAN VERTICAL
DATUM OF 1988 (NAVD88)

CADD FILE:
BENC0501_C1-1.dwg

NO.	DATE	BY	REVISION

ATLAS Surveying and Mapping, Inc.
612 SKYLAKE DRIVE, WEST PALM BEACH, FLORIDA, 33415
CELL (561)-248-8339 LB:7449 ATLASAMI@AOL.COM

SEAL
JOHN P. CAIRNES
FLORIDA P.E. NO. 74737
DATE


FLORIDA C.A. NO. 48
FLORIDA L.B. NO. 48
FIELD: ---
DRAWN: MCV
DESIGN: JPC
APPR: GGG
SCALE: AS SHOWN

MOCK•ROOS
CONSULTING ENGINEERS
5720 Corporate Way, West Palm Beach, Florida 33407 (561) 683-3113, www.MockRoos.com

DATE: MARCH 2021
P.A. NO. C0061.00
DWG. NO. 43-42-27-20
SHEET: C1-1

BENOIST FARMS ROAD
UTILITY ADJUSTMENTS
PALM BEACH COUNTY
WATER UTILITIES DEPARTMENT
PALM BEACH COUNTY, FL

Tapping sleeve not solid sleeve
Restraint Asbuilts?

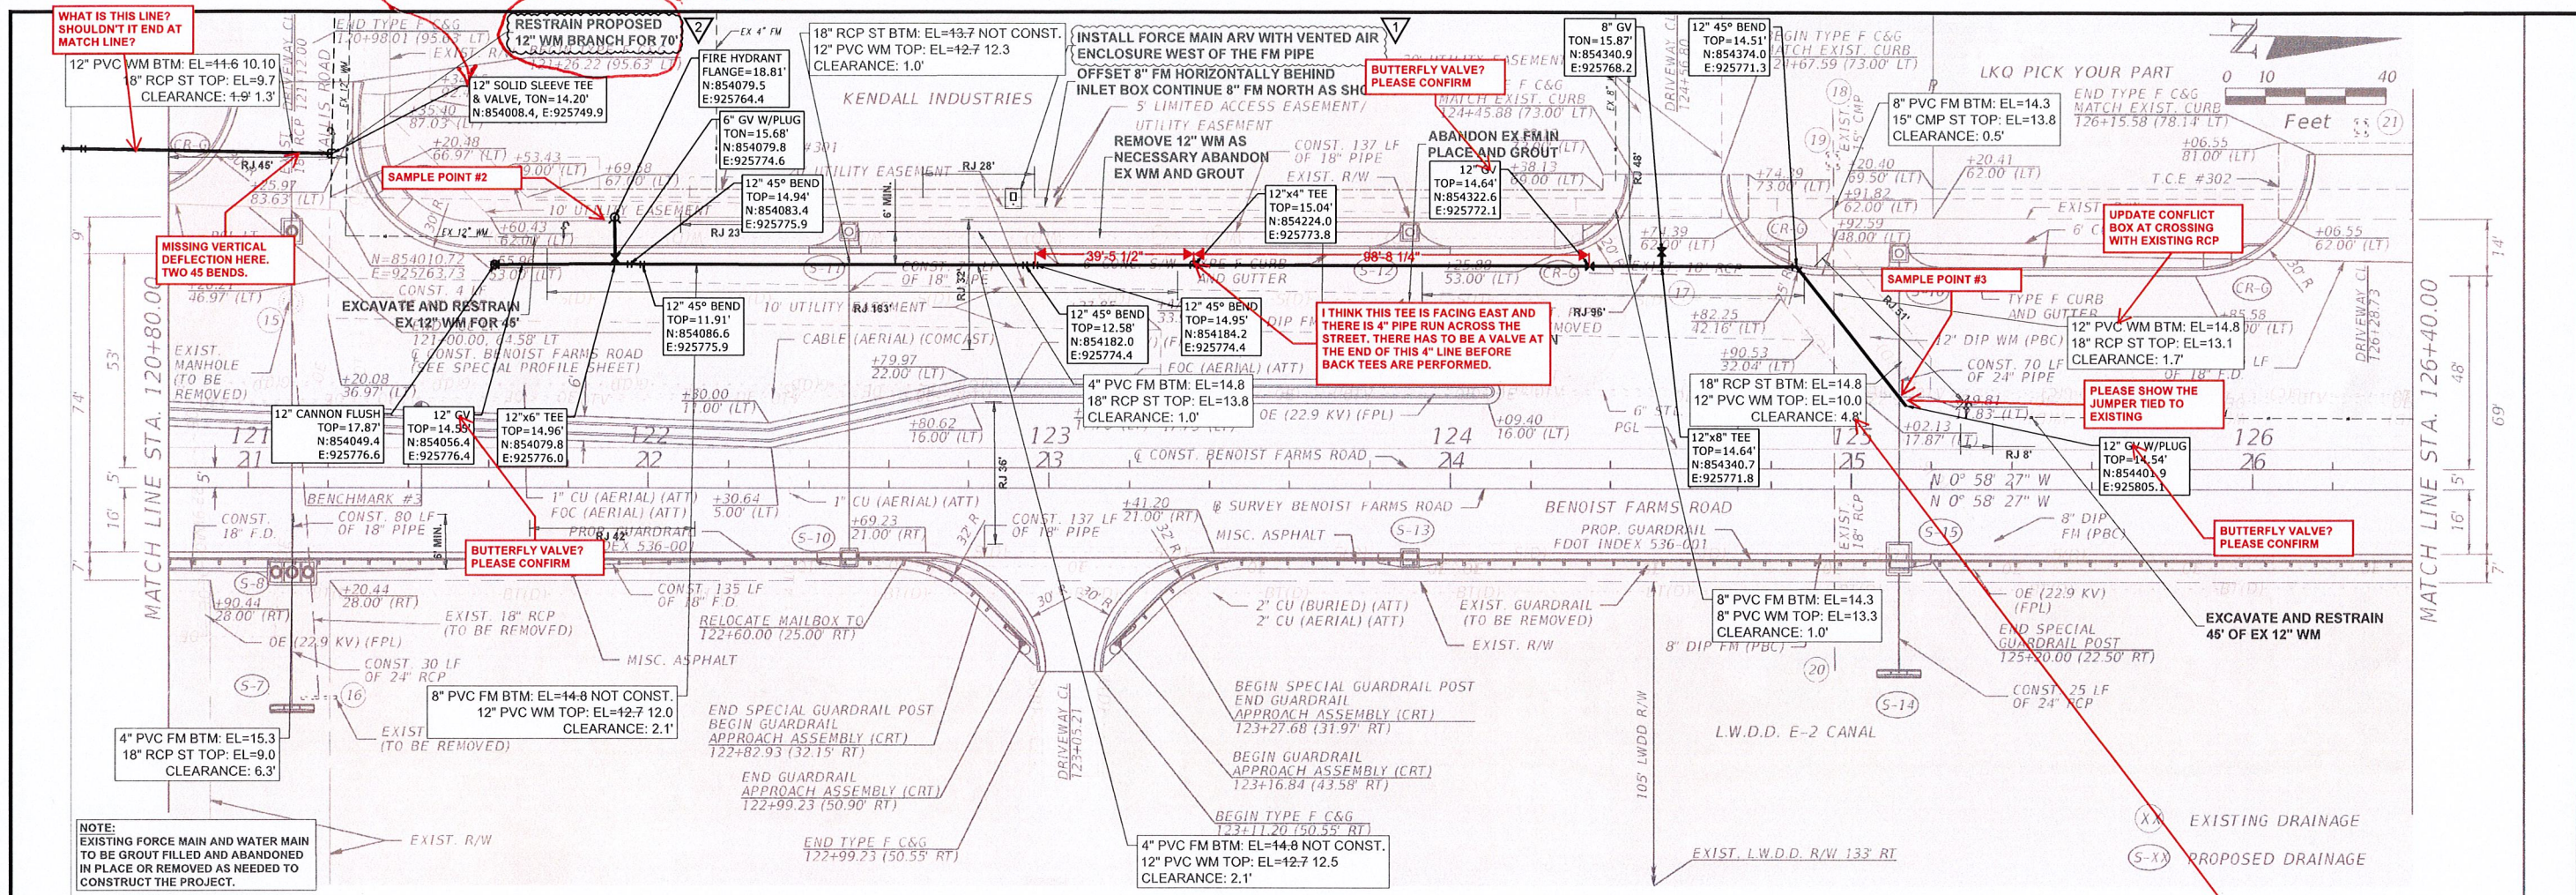

Conflict Boxes Font to match other asbuilts Font

